



DEPARTMENT OF PERMITTING, ENVIRONMENT, AND REGULATORY
AFFAIRS (PERA)

BOARD AND CODE ADMINISTRATION DIVISION

NOTICE OF ACCEPTANCE (NOA)

MIAMI-DADE COUNTY
PRODUCT CONTROL SECTION

11805 SW 26 Street, Room 208

Miami, Florida 33175-2474

T (786) 315-2590 F (786) 315-2599

www.miamidade.gov/pera/

V-Tech Industries, L.P.
5534 Harvey Wilson Drive
Houston, TX 77020

SCOPE: This NOA is being issued under the applicable rules and regulations governing the use of construction materials. The documentation submitted has been reviewed and accepted by Miami-Dade County PERA -Product Control Section to be used in Miami Dade County and other areas where allowed by the Authority Having Jurisdiction (AHJ).

This NOA shall not be valid after the expiration date stated below. The Miami-Dade County Product Control Section (In Miami Dade County) and/or the AHJ (in areas other than Miami Dade County) reserve the right to have this product or material tested for quality assurance purposes. If this product or material fails to perform in the accepted manner, the manufacturer will incur the expense of such testing and the AHJ may immediately revoke, modify, or suspend the use of such product or material within their jurisdiction. PERA reserves the right to revoke this acceptance, if it is determined by Miami-Dade County Product Control Section that this product or material fails to meet the requirements of the applicable building code.

This product is approved as described herein, and has been designed to comply with the Florida Building Code, including the High Velocity Hurricane Zone.

DESCRIPTION: Series SSF, CAP and CMC Plastic Frame Skylights

APPROVAL DOCUMENT: Drawing No. 11-118, titled "Series Seamless Self-Flashing Glazed Skylight (SSF) and Series Curb-Mounted Glazed Skylight (CAP) and Series Curb-Mounted Glazed Skylight (CMC), L.M.I. Resistant-Insulated Glass", Sheets 1 through 8 of 8 (including 7A), dated 09/27/2010, prepared by Tilteco, Inc., signed and sealed by Walter A. Tillit, Jr., P.E., bearing the Miami-Dade County Product Control revision stamp with the Notice of Acceptance number and expiration date by the Miami-Dade County Product Control Section.

MISSILE IMPACT RATING: Large and Small Missile Impact Resistant

LABELING: Each unit shall bear a permanent label with the manufacturer's name or logo, city, state, model/series, and following statement: "Miami-Dade County Product Control Approved", unless otherwise noted herein.

RENEWAL of this NOA shall be considered after a renewal application has been filed and there has been no change in the applicable building code negatively affecting the performance of this product.

TERMINATION of this NOA will occur after the expiration date or if there has been a revision or change in the materials, use, and/or manufacture of the product or process. Misuse of this NOA as an endorsement of any product, for sales, advertising or any other purposes shall automatically terminate this NOA. Failure to comply with any section of this NOA shall be cause for termination and removal of NOA.

ADVERTISEMENT: The NOA number preceded by the words Miami-Dade County, Florida, and followed by the expiration date may be displayed in advertising literature. If any portion of the NOA is displayed, then it shall be done in its entirety.

INSPECTION: A copy of this entire NOA shall be provided to the user by the manufacturer or its distributors and shall be available for inspection at the job site at the request of the Building Official.

This NOA revises NOA # 10-1004.03 and consists of this page 1 and evidence pages E-1 and E-2, as well as approval document mentioned above.

The submitted documentation was reviewed by Carlos M. Utrera, P.E.



CF Utrera
04/10/2012

NOA No. 11-1206.05
Expiration Date: June 10, 2014
Approval Date: February 9, 2012
Page 1

NOTICE OF ACCEPTANCE: EVIDENCE SUBMITTED

A. DRAWINGS


1. Drawing No. 11-118, titled "Series Seamless Self-Flashing Glazed Skylight (SSF) and Series Curb-Mounted Glazed Skylight (CAP) and Series Curb-Mounted Glazed Skylight (CMC), L.M.I. Resistant-Insulated Glass", Sheets 1 through 8 of 8 (including 7A), dated 09/27/2010, prepared by Tilteco, Inc., signed and sealed by Walter A. Tillit, Jr., P.E.

B. TESTS "Submitted under NOA # 10-1004.03"

1. Test reports on 1) Air Infiltration Test, per FBC, TAS 202-94
2) Uniform Static Air Pressure Test, Loading per FBC TAS 202-94
3) Water Resistance Test, per FBC, TAS 202-94
4) Large Missile Impact Test per FBC, TAS 201-94
5) Cyclic Wind Pressure Loading per FBC, TAS 203-94
along with marked-up drawings and installation diagram of Series/Models 4 x 4 (CMC) Hurricane glass skylights, prepared by Architectural Testing, Inc., Test Reports No. 92239.04-801-18 (Rev. 1) and 92239.05-801-18, both dated 09/28/2010 and signed and sealed by Joseph A. Reed, P.E.
2. Test report on Tensile Strength of Plastics per ASTM D638-03 before and after weathering for 4500 hrs per ASTM G 155-00, prepared by ETC Laboratories, Test Report No. ETC-08-1146-21854.1, dated 07/14/2009, signed and sealed by Joseph L. Doldan, P.E. "Submitted under NOA # 09-0929.06"

"Submitted under NOA # 09-0316.03"

3. Test reports on 1) Air Infiltration Test, per FBC, TAS 202-94
2) Uniform Static Air Pressure Test, Loading per FBC TAS 202-94
3) Water Resistance Test, per FBC, TAS 202-94
4) Large Missile Impact Test per FBC, TAS 201-94
5) Cyclic Wind Pressure Loading per FBC, TAS 203-94
along with marked-up drawings and installation diagram of Series Seamless Self-Flashing Glazed Skylight (SSF) and Series Curb-Mounted Glazed Skylight (CAP), prepared by Fenestration Testing Laboratory, Inc., Test Report No. FTL # 5477, dated 02/05/2008, signed and sealed by Carlos S. Rionda, P.E.
4. Test reports on 1) Air Infiltration Test, per FBC, TAS 202-94
2) Uniform Static Air Pressure Test, Loading per FBC TAS 202-94
3) Water Resistance Test, per FBC, TAS 202-94
4) Large Missile Impact Test per FBC, TAS 201-94
5) Cyclic Wind Pressure Loading per FBC, TAS 203-94
along with marked-up drawings and installation diagram of Series Curb-Mounted Glazed Skylight (CAP), prepared by Fenestration Testing Laboratory, Inc., Test Report No. FTL # 4971, dated 12/28/2006, signed and sealed by Michael Wenzel, P.E.
5. Test report on Tensile Strength of Plastics per ASTM D638-03 before and after weathering for per ASTM G 155-00, prepared by ETC Laboratories, Test Report No. ETC-08-1146-21854.0, dated 01/13/2009, signed and sealed by Joseph L. Doldan, P.E.


04/10/2012

Carlos M. Utrera, P.E.

Product Control Examiner

NOA No. 11-1206.05

Expiration Date: June 10, 2014

Approval Date: February 9, 2012

NOTICE OF ACCEPTANCE: EVIDENCE SUBMITTED

B. TESTS (Cont.) "Submitted under NOA # 09-0316.03"

6. Test report on Ignition Properties of Plastics per ASTM D1929-01, prepared by Omega Point Laboratories, Test Report No. **17172-123928**, dated 03/03/05, signed by William E. Fitch, P.E.
7. Test report on Density of Smoke from the Burning or Decomposition of Plastics per ASTM D2843-99, prepared by Omega Point Laboratories, Test Report No. **17172-123931**, dated 03/21/2005, signed by William E. Fitch, P.E.
8. Test report on Rate of Burning and/or Extent and Time of Burning of Plastics in a Horizontal Position of White, Beige and Grey Plaques per ASTM D635-98, prepared by Ghesquiere Plastic Testing, Inc., Test Report No. **0502-65284**, dated 03/02/2005, signed by M. W. Ghesquiere, P.E. *"Submitted under NOA # 09-0316.03"*

C. CALCULATIONS

1. Anchor calculations, prepared by Tilteco, Inc., dated 09/28/2010, signed and sealed by Walter A. Tillit, Jr., P.E. *"Submitted under NOA # 10-1004.03"*
2. Anchor calculations, prepared by Tilteco, Inc., dated 04/22/2008, signed and sealed by Walter A. Tillit, Jr., P.E. *"Submitted under NOA # 09-0316.03"*

D. QUALITY ASSURANCE


1. Miami-Dade Department of Permitting, Environment, and Regulatory Affairs (PERA)

E. MATERIAL CERTIFICATIONS "Submitted under NOA # 09-0316.03"

1. Test report on Fire Resistance of Roof Covering Materials of Curb Mounted Glass Skylight with Plastic Frame per ICC-ES, AC-16 (Class B), prepared by Ramtech Laboratories, Test Report No. **2092-07-07**, dated 03/31/2008, signed by Steven Berggren.
2. Test report on Tensile and Shear Test of #10 x 1-1/2" Phillips Sheet Metal Screws on Wood through Plastic per ASTM D412, prepared by Fenestration Testing Laboratory, Inc., dated 04/28/2008, signed and sealed by Michael Wenzel, P.E.
3. Notice of Acceptance No. **05-1208.02**, issued to E.I. DuPont de Nemours & Co., Inc., for their DuPont Butacite PVB Interlayer, approved on 01/05/2006 and expiring on 12/11/2010.
4. Material Safety Data Sheets of **EFBond DW 646** and **EFBond DV 930**.
5. Technical Data Sheet of **Colo-Fast LM150/100 Arch System**.

F. STATEMENTS

1. Statement letter of code conformance to 2007 and 2010 FBC, issued by Tilteco, Inc., dated 11/28/2011, signed and sealed by Walter A. Tillit, Jr., P.E.
2. No financial interest letter issued by Tilteco, Inc., dated 02/19/2009, signed and sealed by Walter A. Tillit, Jr., P.E. *"Submitted under NOA # 09-0316.03"*

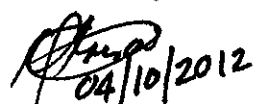

Carlos M. Utrera, P.E.
Product Control Examiner
NOA No. 11-1206.05
Expiration Date: June 10, 2014
Approval Date: February 9, 2012

GENERAL NOTES:

1. SERIES SEAMLESS SELF-FLASHING GLAZED SKYLIGHT (SSF) AND SERIES CURB-MOUNTED GLAZED SKYLIGHTS (CAP) & (CMC), LARGE MISSILE IMPACT RESISTANT-INSULATED GLASS SHOWN ON THIS PRODUCT APPROVAL DOCUMENT (P.A.D.) HAVE BEEN VERIFIED FOR COMPLIANCE IN ACCORDANCE WITH THE 2007 & 2010 EDITIONS OF THE FLORIDA BUILDING CODE. SKYLIGHTS MAY BE INSTALLED AT HIGH VELOCITY HURRICANE ZONES (MIAMI-DADE/BROWARD COUNTIES). DESIGN WIND LOADS SHALL BE DETERMINED AS PER SECTION 1620 OF THE ABOVE MENTIONED CODES, USING ASCE 7-05 STANDARD FOR INSTALLATIONS UNDER 2007 FBC & ASCE 7-10 FOR INSTALLATIONS UNDER 2010 FBC AND SHALL NOT EXCEED THE MAXIMUM (A.S.D.) DESIGN PRESSURE RATINGS INDICATED ON NOTE 2.
IN ORDER TO VERIFY THE ABOVE CONDITION, ULTIMATE DESIGN WIND LOADS DETERMINED PER ASCE 7-10 SHALL BE FIRST REDUCED TO A.S.D. DESIGN WIND LOADS BY MULTIPLYING THEM BY 0.6 IN ORDER TO COMPARE THESE W/ MAX. (A.S.D) DESIGN PRESSURE RATINGS INDICATED ON NOTE 2.
IN ORDER TO VERIFY THAT ANCHORS ON THIS P.A.D., AS TESTED, WERE NOT OVERSTRESSED, NO INCREASE IN ALLOWABLE STRESS FOR WIND LOADS WAS USED IN THEIR ANALYSIS, PERFORMED PER SECTION 1612 OF THE FLORIDA BUILDING CODE.
SKYLIGHT'S ADEQUACY FOR IMPACT AND WIND RESISTANCE HAS BEEN VERIFIED IN ACCORDANCE WITH SECTION 1628 OF THE ABOVE MENTIONED CODES AS PER PROTOCOLS TAS-201, TAS-202, TAS-203, PER FENESTRATION TESTING LABORATORY LAB REPORTS # 4971 (FOR CAP) & 5477 (FOR SSF) AND PER ARCHITECTURAL TESTING LABORATORY REPORT # 92239.04-801-18 (FOR CMC) AND PER A.S.T.M. STANDARDS AND F.B.C. SECTIONS INDICATED ON SCHEDULE SHOWN ON THIS SHEET, PER TESTING PERFORMED BY OMEGA POINT SERVICES, GHESQUIERE PLASTIC TESTING, INC., ETC LABORATORIES, RAMTECH, ATLAS WEATHERING SERVICES GROUP DSET AND RECTICEL NORTH AMERICA LABORATORIES.
2. **MAXIMUM DESIGN PRESSURE RATING FOR THESE SKYLIGHTS ARE:**

SKYLIGHT SYSTEM	A.S.D. DESIGN PRESSURE RATING
SSF/CAP	±75.0 paf
CMC	±85.0 paf
3. **THIS SKYLIGHT WILL NOT REQUIRE A HURRICANE PROTECTION DEVICE.**
4. **THIS SKYLIGHT IS ALSO APPROVED FOR AIR AND WATER INFILTRATION.**
5. REMAINING COMPONENTS FOR THESE SKYLIGHTS SHALL BE AS INDICATED ON BILL OF MATERIALS, SHEET 2 OF THIS DRAWING.
6. SKYLIGHTS SHALL BE INSTALLED SEPARATED FROM EACH OTHER A DISTANCE OF NO LESS THAN 4'-0" MEASURED IN A HORIZONTAL PLANE AS PER SECTION 2607.4 OF THE FLORIDA BUILDING CODE.
7. SKYLIGHT'S FRAME CORRESPOND TO COLO-FAST? LM150/100 ARCH SYSTEM (SEE MECHANICAL PROPERTIES BELOW) PRODUCED BY RECTICEL, DAMSTRAAT 2, B9230-BELGIUM, THAN IS AN ALIPHATIC THREE-COMPONENT POLYURETHANE SYSTEM, DESIGNED FOR REACTION INJECTION MOLDING, RESULTING IN A MICRO-CELLULAR FLEXIBLE ELASTOMER.
COMPONENTS CONSIST OF:
POLYFAST 150/100 IS A MIXTURE OF POLYOLS, CATALYSTS, ANTI-OXYDANTS.
COLORPASTE XXXXP IS A MIXTURE OF POLYOLS AND COLORPASTES; THE NUMBER IS DEPENDING ON THE REQUIRED COLOR.*
ISOFAST 250/100 IS A MIXTURE OF AN ISOPHORONDIISOCYANATE MODIFICATION, CATALYSTS AND ANTI-OXYDANTS.

MECHANICAL PROPERTIES			
SYSTEM	TEST METHOD	UNIT	LM150/100 ARCH
MOULDED DENSITY (Kg/m³)	ISO 1183	Kg/m³	1080
HARDNESS SHORE A	ASTM D2240 (0.5)	-----	80
	DIN 53505 (3 s)	-----	88
	ISO 888 (15 s)	-----	85
HARDNESS SHORE D	ASTM D2240 (0.5)	-----	38
	DIN 53505 (3 s)	-----	31
	ISO 888 (15 s)	-----	28
ELONGATION	ISO 527	%	188
TENSILE STRENGTH	ISO 527	MPa	12
TENSILE RESISTANCE	ISO 34	KN/m	32
	ASTM D824/C	N/cm	480
WATER ABSORPTION (72h/2°C)	ASTM D570	%	4.4
FLEXURAL MODULUS	ASTM D780 IB	MPa	62

* **QUALIFIED COLORS:**

WHITE
BEIGE
GRAY

8. EFBOND DV 930 IS A PRIMING SUBSTANCE USED IN GLAZING PENETRATION INTO FRAME. SEE TABLE OF PHYSICAL AND CHEMICAL PROPERTIES ON SHEET 2.
9. EFBOND DW 646 IS LAYER TO PROMOTE ADHESION USED IN GLAZING PENETRATION INTO FRAME. SEE TABLE OF PHYSICAL AND CHEMICAL PROPERTIES ON SHEET 2.
10. **ANCHOR SPECIFICATIONS.** SEE ITEM #7 ON SHEET 2 ON BILL OF MATERIALS.
11. WOOD CURBS OR SUPPORT NOT BY V-TECH INDUSTRIES, MUST BE PROPERLY ANCHORED AND DESIGNED BY PROFESSIONAL OF RECORD TO TRANSFER ALL LOADS TO THE BUILDING STRUCTURE AND MUST BE APPROVED BY BUILDING OFFICIAL AT THE TIME PERMIT IS APPLIED FOR. WOOD TO BE SOUTHERN PINE, G = 0.55.

12. SKYLIGHT'S MANUFACTURER LABEL SHALL BE PLACED ON A READILY VISIBLE LOCATION. ONE LABEL SHALL BE PLACED FOR EVERY UNIT. LABEL SHALL READ AS FOLLOWS:

V-TECH INDUSTRIES
HOUSTON, TEXAS
MIAMI-DADE COUNTY PRODUCT CONTROL APPROVED.

13. (a) THIS P.A.D. PREPARED BY THIS ENGINEER IS GENERIC AND DOES NOT PROVIDE INFORMATION FOR A SITE SPECIFIC PROJECT; I.e. WHERE THE SITE CONDITIONS DEViate FROM THE P.A.D.
(b) CONTRACTOR TO BE RESPONSIBLE FOR THE SELECTION, PURCHASE AND INSTALLATION INCLUDING LIFE SAFETY OF THIS PRODUCT, BASED ON THIS P.A.D., PROVIDED HE/SHE DOES NOT DEVIATE FROM THE CONDITIONS DETAILED ON THIS DOCUMENT. CONSTRUCTION SAFETY AT SITE IS THE CONTRACTOR'S RESPONSIBILITY.
(c) THIS P.A.D. WILL BE CONSIDERED INVALID IF ALTERED BY ANY MEANS.
(d) SITE SPECIFIC PROJECTS SHALL BE PREPARED BY A FLORIDA REGISTERED ENGINEER OR ARCHITECT WHICH WILL BECOME THE ENGINEER OF RECORD (E.O.R.) FOR THE PROJECT AND WHO WILL BE RESPONSIBLE FOR THE PROPER USE OF THE P.A.D. ENGINEER OF RECORD, ACTING AS DELEGATED ENGINEER TO THE P.A.D. ENGINEER, SHALL SUBMIT TO THIS LATTER THE SITE SPECIFIC DRAWINGS FOR REVIEW.
(e) ORIGINAL P.A.D. SHALL BEAR THE DATE AND ORIGINAL SEAL AND SIGNATURE OF THE PROFESSIONAL ENGINEER OF RECORD THAT PREPARED IT.


SCHEDULE OF STANDARDS USED TO VERIFY MATERIAL PROPERTIES OF SKYLIGHTS

MATERIAL PROPERTY	STANDARD	TEST RESULTS	TEST REPORT #	LABORATORY	F.B.C. SECTIONS
DENSITY OF SMOKE	ASTM D2843	SMOKE DENSITY 30.7% SMOKE DENSITY RATING 22.2%	17172-123931	OMEGA POINT	2612.2
SELF IGNITION TEMPERATURE	ASTM D1929-96(01) e1	FLASH IGNITION 644°F SPONTANEOUS-IGNITION TEMP. 680°F	17172-123928	OMEGA POINT	2612.2
RATE OF BURNING &/OR EXTENT & TIME OF BURNING OF PLASTICS IN A HORIZONTAL POSITION	ASTM D635-98	>1 in./min. (C-1)	0502-65284	GHESQUIERE PLASTIC TESTING, INC.	2612.2
WEATHERING	ASTM G155-00	WEATHERED FOR: 4500 hrs.		ETC LABORATORIES	2612.2
TENSILE STRENGTH	ASTM D638-03	UNEXPOSED: 1400.04 psi EXPOSED: 1439.59 psi % DIFF.: -2.8%	ETC-08-1146-21854.1		
FIRE RESISTANCE OF ROOF COVERING MATERIALS	UL 790-97	PASSED	2092-07-07	RAMTECH	2610.2 *
TENSILE AND SHEAR STRENGTH OF #10 SCREWS THRU SSF AND CAP FRAME FOR ATTACHMENT INTO WOOD	ASTM D412 (12/06)	TENSION CAPACITY: Tu = 229 Lb SHEAR CAPACITY: Su = 141 Lb	0804-1044	FENESTRATION TESTING LAB P.E. WITNESSING IN PLANT TESTING	1612.1 & 1625.1

* NOTE: NOT REQUIRED FOR HIGH VELOCITY HURRICANE ZONES, BUT IT WAS STILL PERFORMED TO BE CERTAIN ABOUT THE FIRE RESISTANCE OF THIS GLAZED SKYLIGHT.

PRODUCT REVISED
as complying with the Florida
Building Code
Acceptance No 11-1206.05
Expiration Date 06/10/2019
By *[Signature]*
Miami Dade Product Control

MIAMI-DADE COUNTY

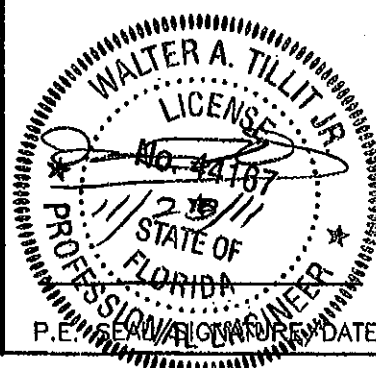

FLORIDA BUILDING CODE (HIGH VELOCITY HURRICANE ZONE)


©2011 TILTECO, INC		SERIES SEAMLESS SELF-FLASHING GLAZED SKYLIGHT (SSF), SERIES CURB-MOUNTED GLAZED SKYLIGHT (CAP) AND SERIES CURB-MOUNTED GLAZED SKYLIGHT (CMC) LARGE MISSILE IMPACT RESISTANT-INSULATED GLASS			M.C.V./A.G. DRAWN BY	
<div><div>TILTECO INC.</div><div>TILLIT TESTING & ENGINEERING COMPANY 6395 N.W. 36th, St., Ste. 308, VIRGINIA GARDENS, FL 33166 Phone : (305)971--1830 , Fax : (305)971--1531 e-mail: tilteco@aol.com EB-0006719 WALTER A. TILLIT JR., P.E. FLORIDA Lic. # 44167</div></div>		V-TECH INDUSTRIES 6534 HARVEY WILSON DRIVE HOUSTON, TEXAS 77020 PHONE: (866) 491-0843			11/16/11 DATE	
					11-118 DRAWING No	
REV. No	DESCRIPTION	DATE	REV. No	DESCRIPTION	DATE	SHEET 1 OF
1	OLD 19-086	11/16/11	3	-	-	
2	-	-	4	-	-	

AS PER EFTEC MATERIAL SAFETY DATA SHEET PHYSICAL AND CHEMICAL PROPERTIES FOR "EFBOND DV 930" (5)	
GENERAL INFORMATION	
FORM:	LIQUID
COLOUR:	BLACK
ODOUR:	CHARACTERISTIC
- CHANGE UN CONDITION	
MELTING POINT/MELTING RANGE:	UNDETERMINED
BOILING POINT/BOILING RANGE:	78°C
- FLASH POINT:	-4°C
- IGNITION TEMPERATURE:	370.0°C
- SELF-IGNITION:	PRODUCT IS NOT SELFIGNITING
- DANGER OF EXPLOSION:	PRODUCT IS NOT EXPLOSIVE. HOWEVER, FORMATION OF EXPLOSIVE AIR/ VAPOUR MIXTURES ARE POSSIBLE.
- EXPLOSION LIMITS:	
LOWER:	1.8 VOL%
UPPER:	11.5 VOL%
- VAPOUR PRESSURE AT 20°C:	105.0 hPa
- DENSITY AT 20°C:	0.950 g/cm ³
- SOLUBILITY IN / MISCIBILITY	
WITH WATER:	NOT MISCIBLE OR DIFFICULT TO MIX
- SOLVENT CONTENT:	
ORGANIC SOLVENTS:	69.00%
SOLIDS CONTENT:	31.00%


AS PER EFTEC MATERIAL SAFETY DATA SHEET PHYSICAL AND CHEMICAL PROPERTIES FOR "EFBOND DW 648" (6)	
GENERAL INFORMATION	
FORM:	LIQUID
COLOUR:	CLEAR
ODOUR:	ALCOHOL-LIKE
- CHANGE UN CONDITION	
MELTING POINT/MELTING RANGE:	-114.5°C
BOILING POINT/BOILING RANGE:	78°C
- FLASH POINT:	13°C
- IGNITION TEMPERATURE:	425.0°C
- SELF-IGNITION:	PRODUCT IS NOT SELFIGNITING
- DANGER OF EXPLOSION:	PRODUCT IS NOT EXPLOSIVE. HOWEVER, FORMATION OF EXPLOSIVE AIR/ VAPOUR MIXTURES ARE POSSIBLE.
- EXPLOSION LIMITS:	
LOWER:	3.5 VOL%
UPPER:	15.0 VOL%
- VAPOUR PRESSURE AT 20°C:	59.0 hPa
- DENSITY AT 20°C:	0.797 g/cm ³
- SOLUBILITY IN / MISCIBILITY	
WITH WATER:	1.000 g/l
- SOLVENT CONTENT:	
ORGANIC SOLVENTS:	98.50%
SOLIDS CONTENT:	3.50%

BILL OF MATERIALS					
# ITEM	PART	DESCRIPTION	MATERIAL	USE AT	
				SSF & CAP	CMC
1	FRAME	APPLICABLE ONLY FOR "SQUARE" SHAPE FRAME SERIES: SEAMLESS SELF-FLASHING GLAZED SKYLIGHT (SSF), CORRESPOND TO COLO-FAST® LM150/100 ARCH SYSTEM (SEE NOTE 7/1, AND DETAIL ON SHEET 3)	ALIPAHTIC POLYURETHANE	YES	NO
2	FRAME	APPLICABLE FOR "SQUARE" AND "RECTANGULAR" SHAPES FRAME SERIES: CURB-MOUNTED GLAZED SKYLIGHT (CAP), CORRESPOND TO COLO-FAST® LM150/100 ARCH SYSTEM (SEE NOTE 7/1, AND DETAIL ON SHEET 3)	ALIPAHTIC POLYURETHANE	YES	NO
2A	FRAME	APPLICABLE FOR "SQUARE" SHAPE FRAME SERIES: CURB-MOUNTED GLAZED SKYLIGHT (CMC), CORRESPOND TO COLO-FAST® LM150/100 ARCH SYSTEM (SEE NOTE 7/1, AND SEE COMPONENT ON SHEET 3)	ALIPAHTIC POLYURETHANE	NO	YES
3	FRAME	APPLICABLE ONLY FOR "RECTANGULAR" SHAPE FRAME SERIES: SEAMLESS SELF-FLASHING (SSF) SKYLIGHT, GLASS GLAZED SKYLIGHT, CORRESPOND TO COLO-FAST® LM150/100 ARCH SYSTEM (SEE NOTE 7/1, AND DETAIL ON SHEET 3)	ALIPAHTIC POLYURETHANE	YES	NO
4	GLASS	3/4" OVERALL THICKNESS 1/8" TEMPERED GLASS (EXTERIOR LITE) + 1/4" AIR SPACE + 1/8" H.S. GLASS (INTERIOR LITE) WITH A 0.120" INTERLAYER FILM, DUPONT BUTACITE® PVB MANUFACTURED BY EI DUPONT DE NEMOURS & CO, INC, LAMINATED BY CARDINAL GLASS + 1/8" H.S. GLASS (INTERIOR LITE).	IMPACT RESISTANT INSULATED GLASS	YES	NO
4A	GLASS	3/4" OVERALL THICKNESS 5/32" TEMPERED GLASS (EXTERIOR LITE) + 1/4" AIR SPACE + 3/32" H.S. GLASS (INTERIOR LITE) WITH A 0.120" INTERLAYER FILM, DUPONT BUTACITE® PVB MANUFACTURED BY EI DUPONT DE NEMOURS & CO, INC, LAMINATED BY CARDINAL-GLASS + 3/32" H.S. GLASS (INTERIOR LITE).	IMPACT RESISTANT INSULATED GLASS	NO	YES
5	GLAZING SEALANT	EDBOND DV 930, SEE PHYSICAL AND CHEMICAL PROPERTIES ON THIS SHEET.	PRIMER	YES	YES
6	GLAZING SEALANT	EDBOND DW 648, SEE PHYSICAL AND CHEMICAL PROPERTIES ON THIS SHEET.	ADHESIVE	YES	YES
7	ANCHORS TO WOOD	#10 x 1 1/2" PHILLIPS SHEET METAL SCREW TO WOOD FRAME W/ 1.22" MIN. THREADED PENETRATION FOR TENSION CAPACITY (AT SSF) AND 1.20" MIN. THREADED PENETRATION FOR SHEAR CAPACITY (AT CAP AND CMC).	NON CORROSIVE STEEL	YES	YES


PRODUCT REVISED as complying with the Florida Building Code Acceptance No. 11-1206-05 Expiration Date 06/10/2014 By <i>[Signature]</i> Miami Dade Product Control		FLORIDA BUILDING CODE (HIGH VELOCITY HURRICANE ZONE)	
MIAMI-DADE COUNTY		©2011 TILTECO, INC. TILLIT TESTING & ENGINEERING COMPANY 8355 N.W. 38th St., Ste. 305, VIRGINIA GARDENS, FL 33166 Phone: (305) 871-1530 Fax: (305) 871-1531 e-mail: tiltco@col.com EB-0008719 WALTER A. TILLIT Jr. P.E. FLORIDA Lic. # 44167	
		SERIES SEAMLESS SELF-FLASHING GLAZED SKYLIGHT (SSF), SERIES CURB-MOUNTED GLAZED SKYLIGHT (CAP) AND SERIES CURB-MOUNTED GLAZED SKYLIGHT (CMC) LARGE MISSILE IMPACT RESISTANT-INSULATED GLASS V-TECH INDUSTRIES 5534 HARVEY WILSON DRIVE HOUSTON, TEXAS 77020 PHONE: (889) 491-0843	
M.C.V./A.G. DRAWN BY		11/16/11 DATE	
11-118 DRAWING No		SHEET 2 OF 8	

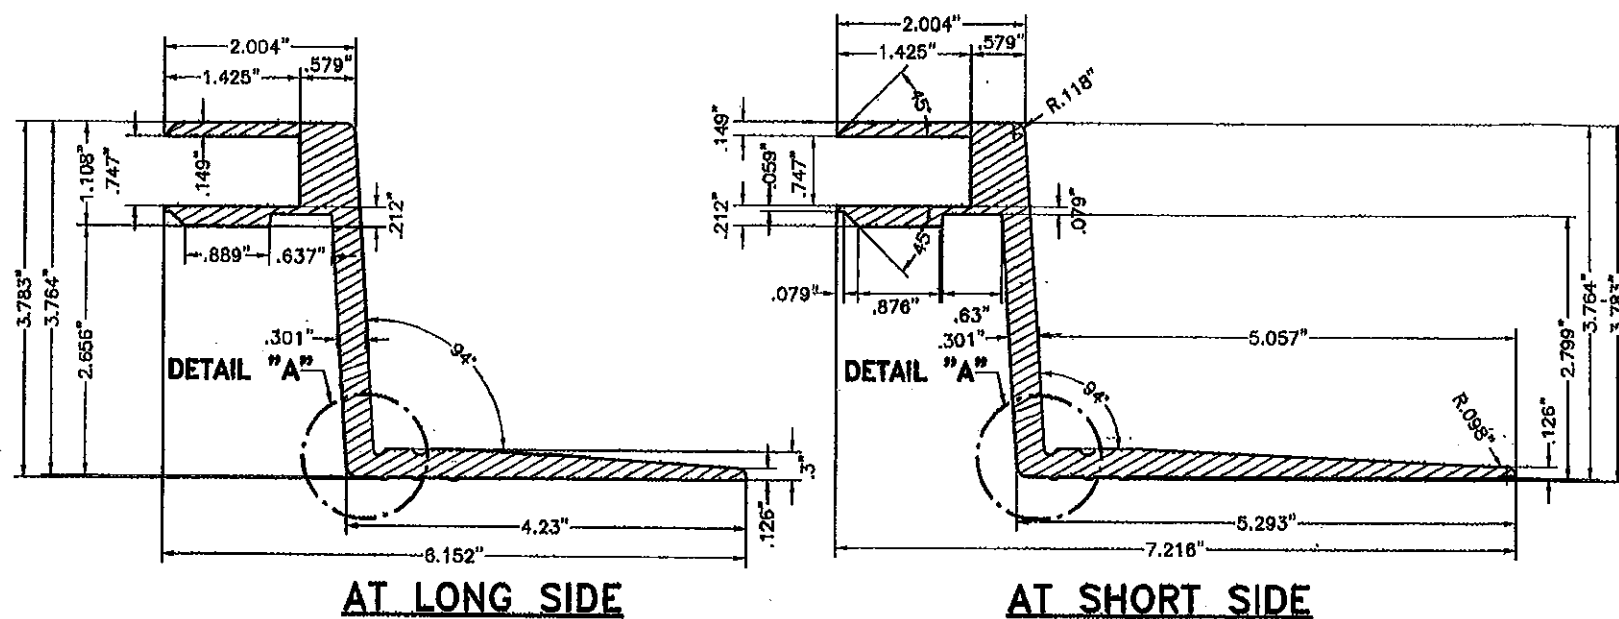


① "SQUARE" SHAPE FRAME (SSF)

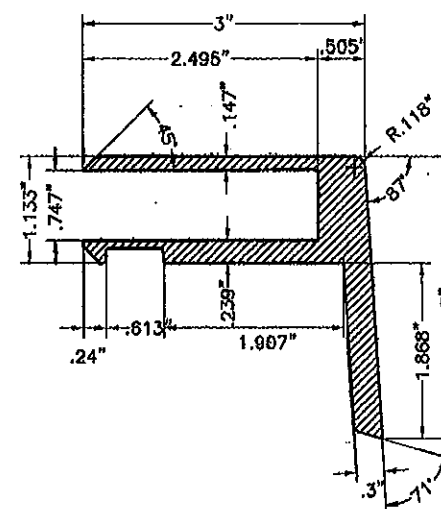


② "SQUARE" SHAPE FRAME (CAP)

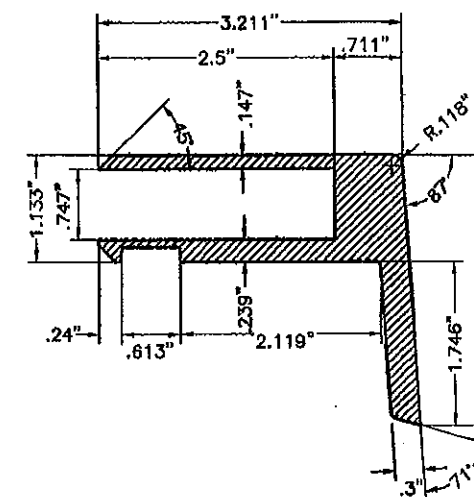


②A "SQUARE" SHAPE FRAME (CMC)

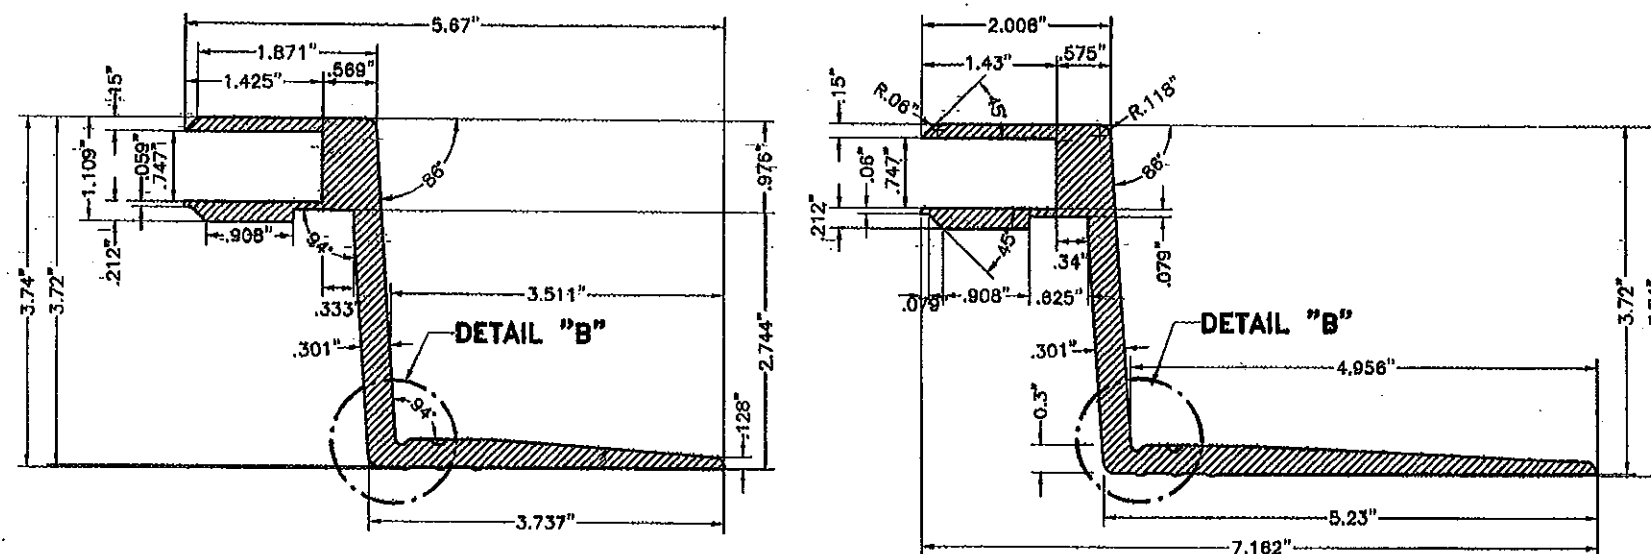

③ "RECTANGULAR" SHAPE FRAME (SSF)

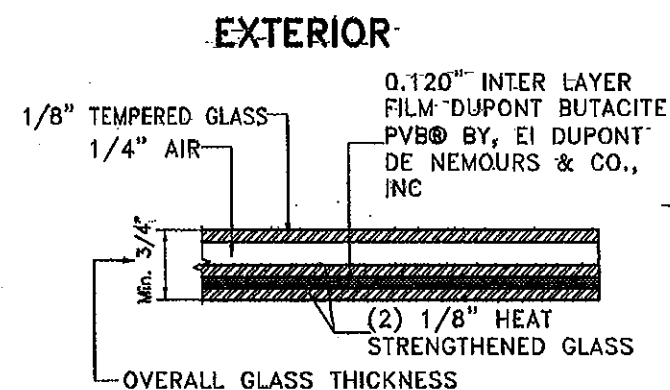

④ GLASS

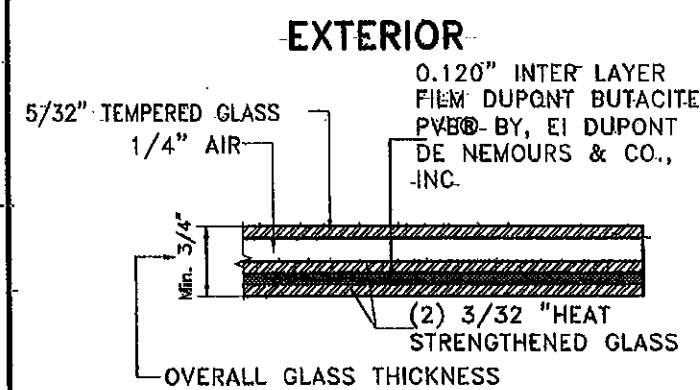


④A GLASS

COMPONENTS FOR SERIES SSF AND CAP ONLY

SCALE: 1/2"=1"

COMPONENTS FOR SERIES CMC ONLY

SCALE: 1/2"=1"

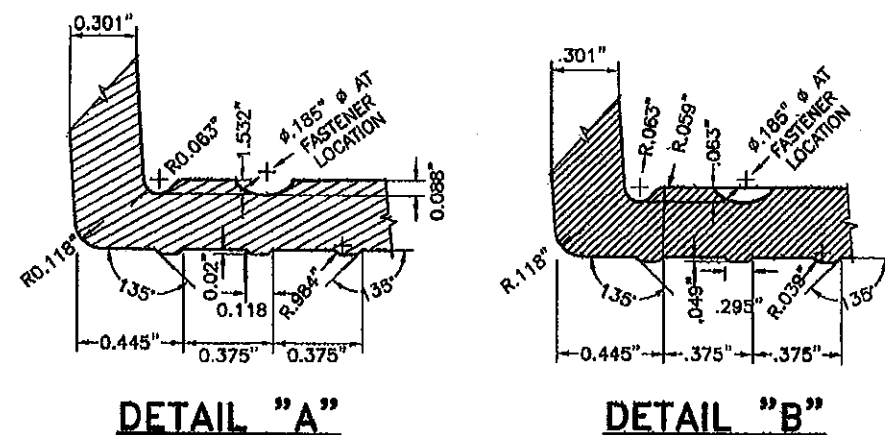

DETAIL "A"

DETAIL "B"

PRODUCT REVISED as complying with the Florida Building Code
Acceptance No 11-1206.05
Expiration Date 06/10/2014
By [Signature]
Miami Dade Product Control

MIAMI-DADE COUNTY

WALTER A. TILLIT JR.
LICENSE
No. 74107
11/23/11
STATE OF FLORIDA
PROFESSIONAL ENGINEER
P.E. SIGNATURE DATE

FLORIDA BUILDING CODE (HIGH VELOCITY HURRICANE ZONE)

©2011 TILTECO, INC

TILTECO INC.
TILLIT TESTING & ENGINEERING COMPANY
6385 N.W. 38th St., Ste. 305, VIRGINIA GARDENS, FL 33168
Phone: (305) 871-1530 Fax: (305) 871-1531
e-mail: tilteco@tel.com
EB-0006719
WALTER A. TILLIT Jr. P.E.
FLORIDA Lic. # 44167

SERIES SEAMLESS SELF-FLASHING GLAZED SKYLIGHT (SSF),
SERIES CURB-MOUNTED GLAZED SKYLIGHT (CAP) AND
SERIES CURB-MOUNTED GLAZED SKYLIGHT (CMC) LARGE
MISSILE IMPACT RESISTANT-INSULATED GLASS

M.C.V./A.G.
DRAWN BY


V-TECH INDUSTRIES
6534 HARVEY WILSON DRIVE
HOUSTON, TEXAS 77020
PHONE: (888) 491-0843

11/16/11
DATE


11-118
DRAWING No

REV. No	DESCRIPTION	DATE	REV. No	DESCRIPTION	DATE
1	OLD 10-098	11/16/11	2		
2			3		


SHEET 3 OF 8

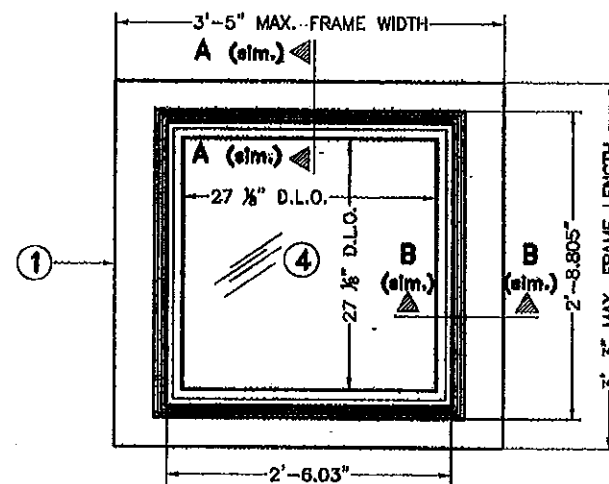

PLAN (INTERIOR SIDE)

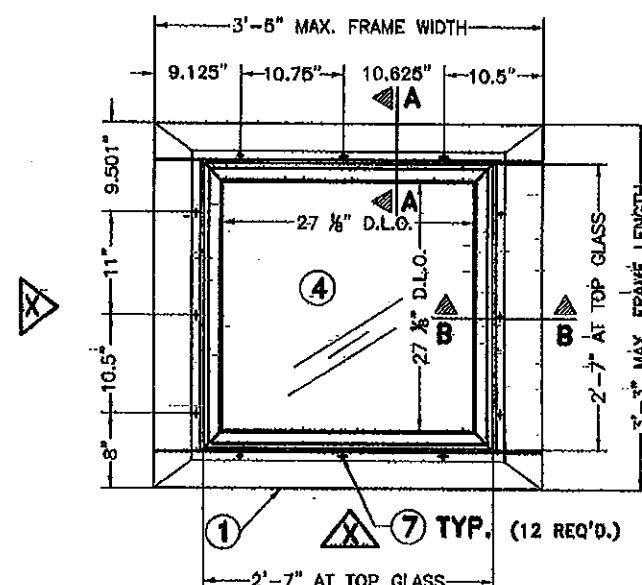


PLAN (EXTERIOR SIDE)

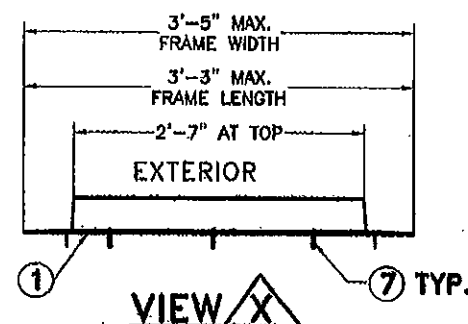


CASE 1: 3'-5"x3'-3" SERIES SEAMLESS
SELF-FLASHING GLAZED SKYLIGHT (S.S.F.)


N.T.S.

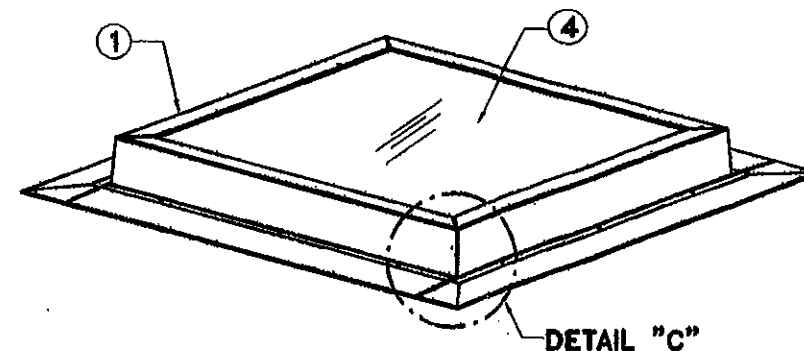


TYPICAL ISOMETRIC

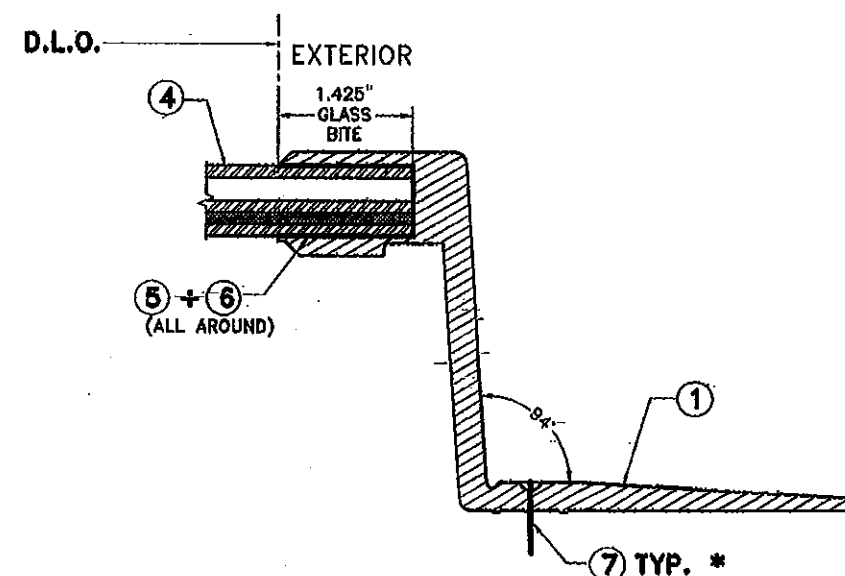

SECTION A-A
SCALE: 1/2"=1"

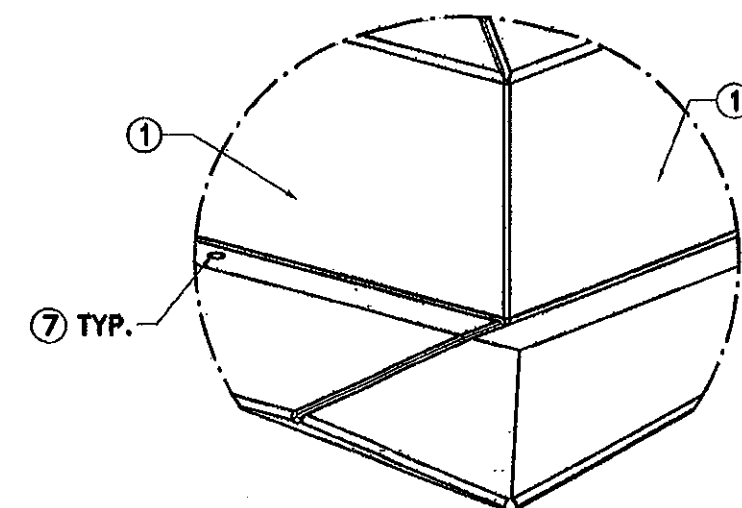

DETAIL "C"

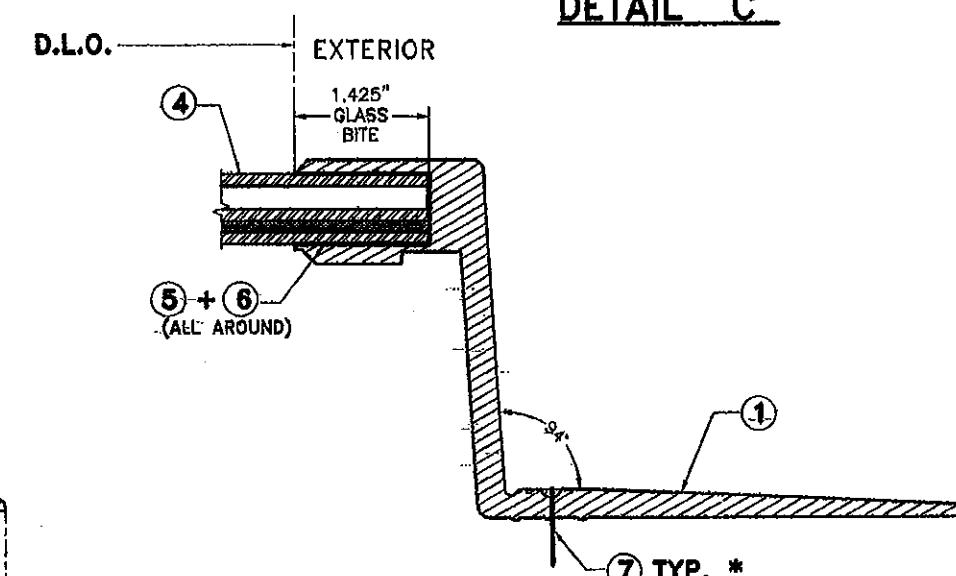


SECTION B-B
SCALE: 1/2"=1"

GLAZING DETAIL

* SEE CONNECTION DETAIL ON SHEET 8/8

PRODUCT REVISED
as complying with the Florida
Building Code
Acceptance No. 11-1206.05
Expiration Date 06/10/2014
By *[Signature]*
Miami-Dade Product Control

MIAMI-DADE COUNTY

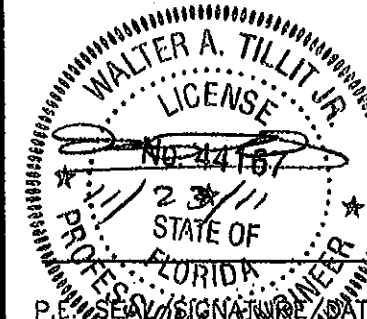

FLORIDA BUILDING CODE (HIGH VELOCITY HURRICANE ZONE)

©2011 TILTECO, INC

TILTECO INC.
TILLIT TESTING & ENGINEERING COMPANY
6385 N.W. 36th St., Ste. 308, VIRGINIA GARDENS, FL 33168
Phone: (305) 871-1830 Fax: (305) 871-1831
e-mail: tilteco@aol.com
EB-0008719
WALTER A. TILLIT Jr., P.E.
FLORIDA Lic. # 44187

SERIES SEAMLESS SELF-FLASHING GLAZED SKYLIGHT (SSF),
SERIES CURB-MOUNTED GLAZED SKYLIGHT (CAP) AND
SERIES CURB-MOUNTED GLAZED SKYLIGHT (CMC) LARGE
MISSILE IMPACT RESISTANT-INSULATED GLASS

M.C.V./A.G.
DRAWN BY


V-TECH INDUSTRIES
6534 HARVEY WILSON DRIVE
HOUSTON, TEXAS 77020
PHONE: (866) 491-0843

11/18/11
DATE


11-118
DRAWING No

REV. No	DESCRIPTION	DATE	REV. No	DESCRIPTION	DATE
1	OLD 10-088	11/18/11	3	--	--
2	--	--	4	--	--


SHEET 4 OF 8

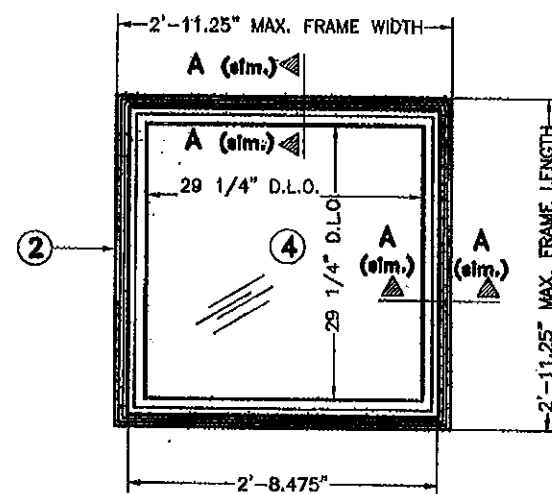


PLAN (INTERIOR SIDE)

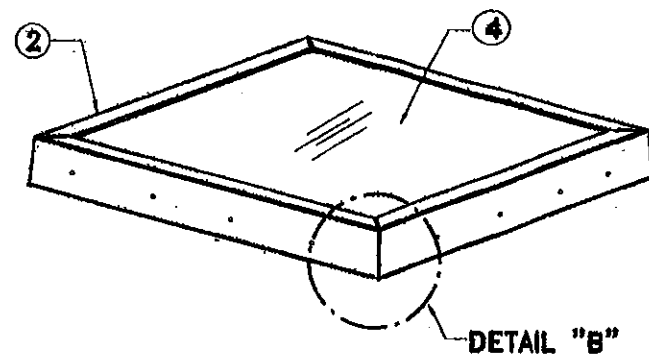


TYPICAL ISOMETRIC

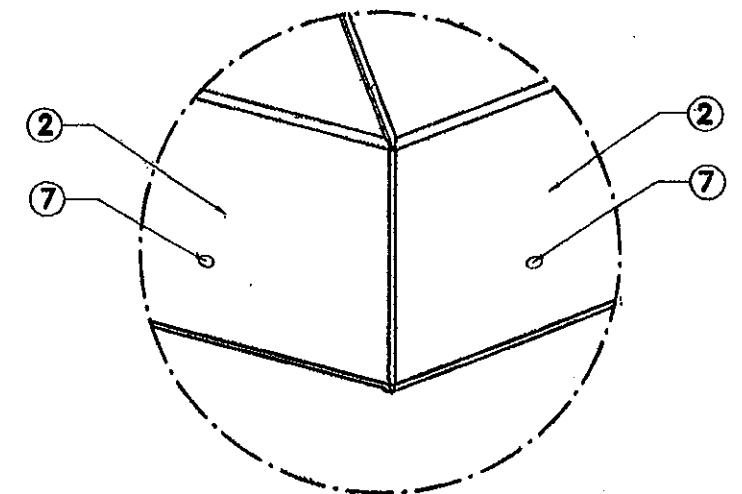

DETAIL "B"

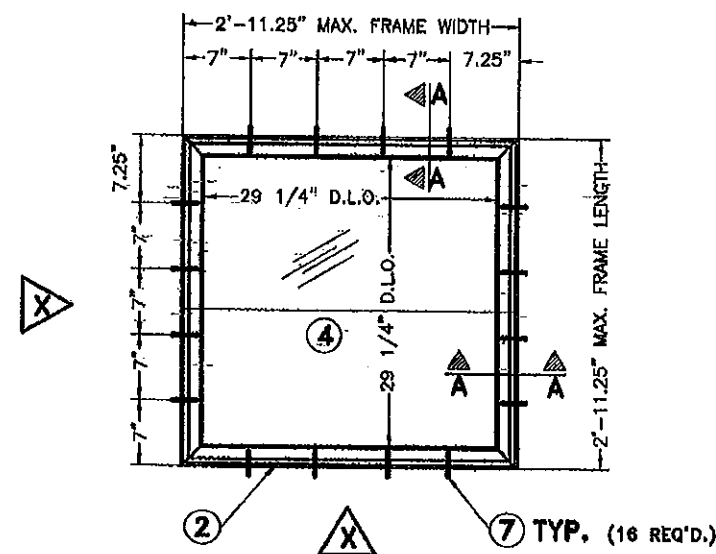


PLAN (EXTERIOR SIDE)

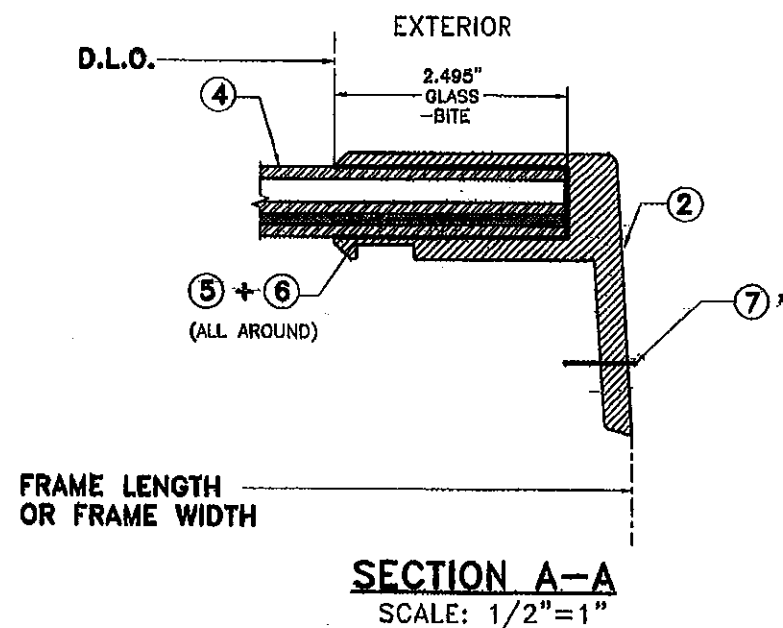

GLAZING DETAIL

* SEE CONNECTION DETAIL ON SHEET 8/8

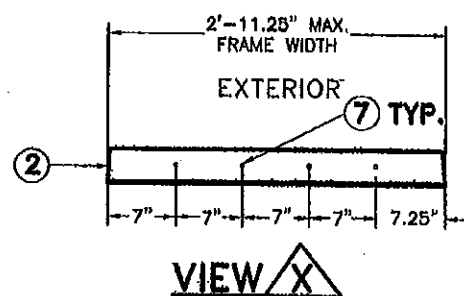


CASE 2: 2'-11 1/4"x2'-11 1/4" SERIES CURB-MOUNTED GLAZED SKYLIGHT (CAP)

N.T.S.

PRODUCT REVISED
as complying with the Florida
Building Code
Acceptance No 11-1206.05
Expiration Date 06/10/2014
By [Signature]
Miami Dade Product Control

MIAMI-DADE COUNTY

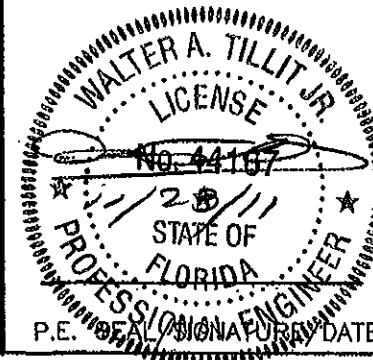

FLORIDA BUILDING CODE (HIGH VELOCITY HURRICANE ZONE)

©2011 TILTECO, INC

TILTECO INC.
TILLIT TESTING & ENGINEERING COMPANY
6385 N.W. 36th St., Ste. 308, VIRGINIA GARDENS, FL 33166
Phone: (305) 871-1830 • Fax: (305) 871-1831
e-mail: tilteco@aol.com
EG-0008719
WALTER A. TILLIT Jr., P.E.
FLORIDA Lic. # 44167

SERIES SEAMLESS SELF-FLASHING GLAZED SKYLIGHT (S8F),
SERIES CURB-MOUNTED GLAZED SKYLIGHT (CAP) AND
SERIES CURB-MOUNTED GLAZED SKYLIGHT (CMC) LARGE
MISSILE IMPACT RESISTANT-INSULATED GLASS

M.C.V./A.G.
DRAWN BY

11/16/11
DATE


11-118
DRAWING No.

V-TECH INDUSTRIES
5534 HARVEY WILSON DRIVE
HOUSTON, TEXAS 77020
PHONE: (866) 481-0843


REV. No	DESCRIPTION	DATE	REV. No	DESCRIPTION	DATE
1	OLD 10-080	11/16/11	3	-	-
2	-	-	4	-	-

SHEET 5 OF 8


PAGE 6 OF 8

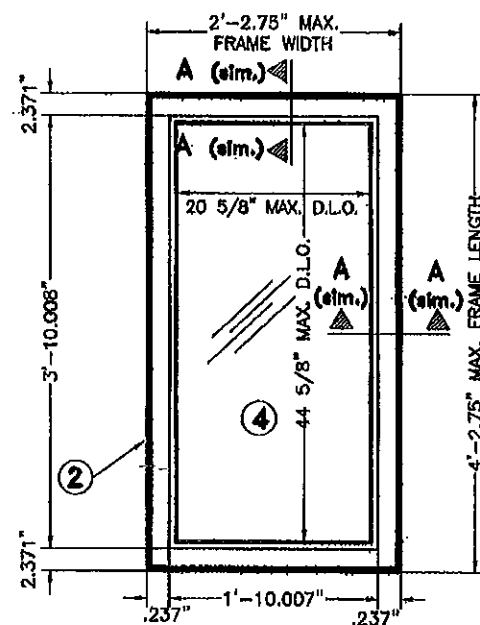


PLAN (INTERIOR SIDE)

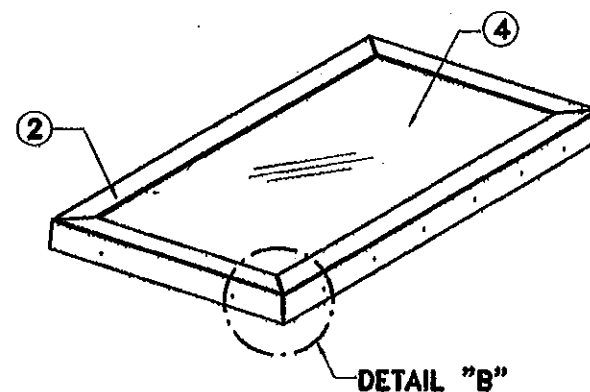




TYPICAL ISOMETRIC

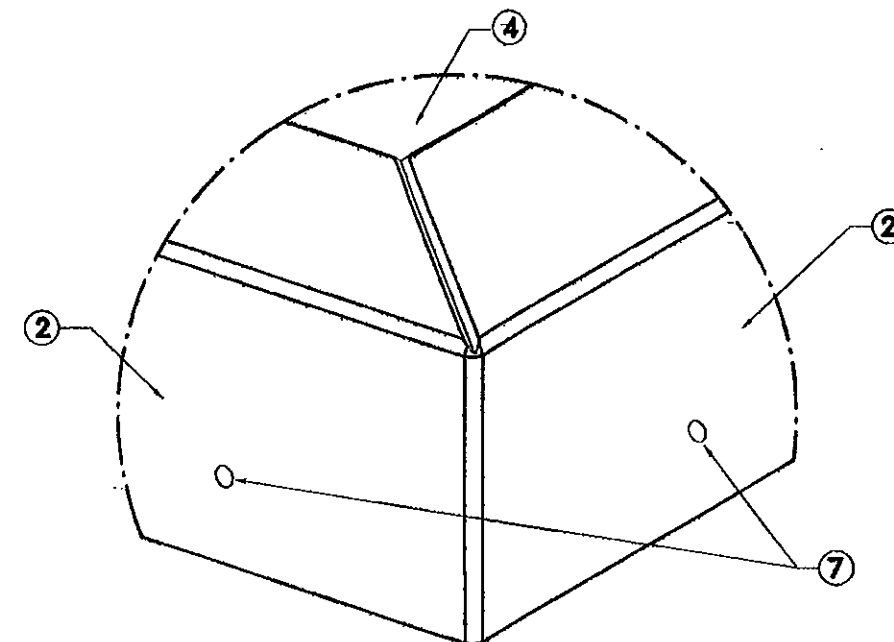

DETAIL "B"

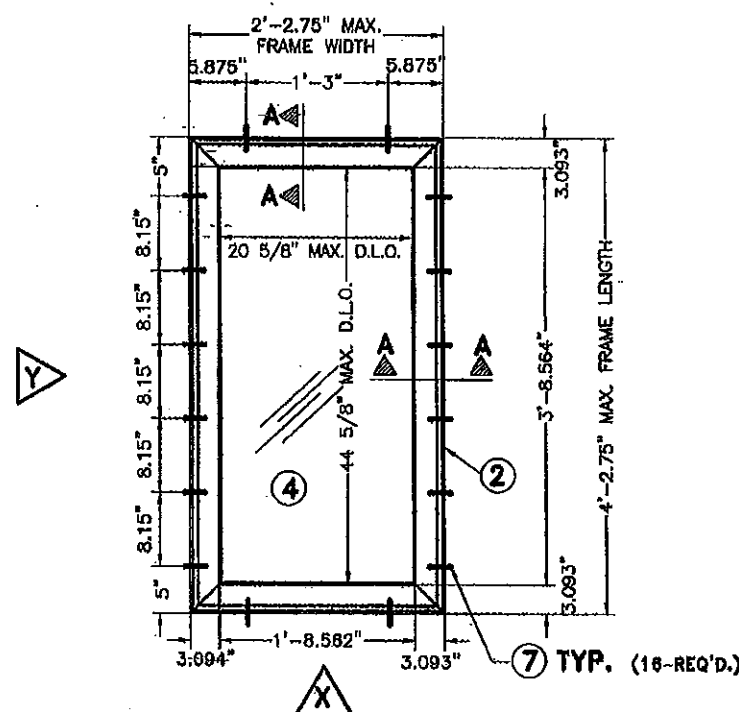

PLAN (EXTERIOR SIDE)

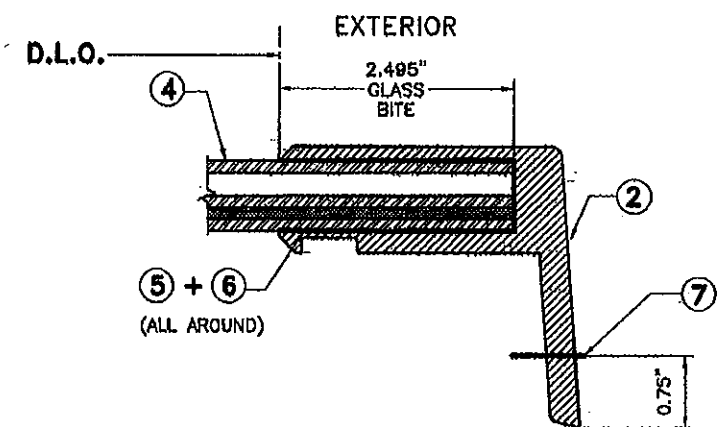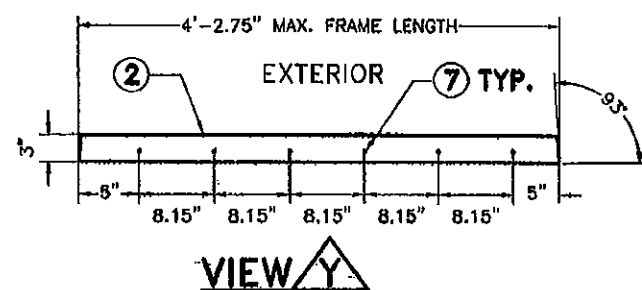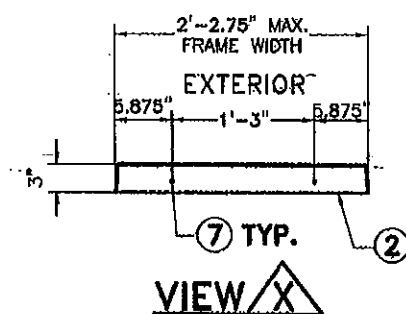

FRAME LENGTH
OR FRAME WIDTH

SECTION A-A
SCALE: 1/2"=1"


GLAZING DETAIL

* SEE CONNECTION DETAIL ON SHEET 8/8

CASE 4: 2'-2 3/4"x4'-2 3/4" SERIES
CURB-MOUNTED GLAZED SKYLIGHT (CAP)
N.T.S.

PRODUCT REVISED
as complying with the Florida
Building Code
Acceptance No. 11-1206.05
Expiration Date 12/10/2014
By [Signature]
Miami Made Product Control

MIAMI-DADE COUNTY

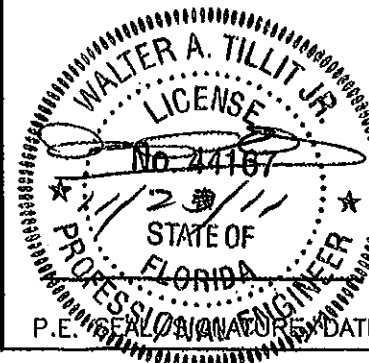

P.E. SEAL SIGNATURE DATE

FLORIDA BUILDING CODE (HIGH VELOCITY HURRICANE ZONE)

©2011 TILTECO, INC

TILTECO Inc.
TILLIT TESTING & ENGINEERING COMPANY
6355 N.W. 36th St., Ste. 305, VIRGINIA GARDENS, FL 33166
Phone : (305) 871-1830 • Fax : (305) 871-1531
e-mail: tilteco@aol.com
EB-0005719
WALTER A. TILLIT JR., P.E.
FLORIDA Lic. # 44187

SERIES SEAMLESS SELF-FLASHING GLAZED SKYLIGHT (SSF),
SERIES CURB-MOUNTED GLAZED SKYLIGHT (CAP) AND
SERIES CURB-MOUNTED GLAZED SKYLIGHT (CMC) LARGE
MISSILE IMPACT RESISTANT-INSULATED GLASS

V-TECH INDUSTRIES

6534 HARVEY WILSON DRIVE
HOUSTON, TEXAS 77020
PHONE: (866) 491-0843

M.C.V./A.G.
DRAWN BY


11/18/11
DATE

11-118


DRAWING No

REV. No	DESCRIPTION	DATE	REV. No	DESCRIPTION	DATE
1	OLD 10-089	11/18/11	3	-	-
2	-	-	4	-	-


SHEET 7 OF 8

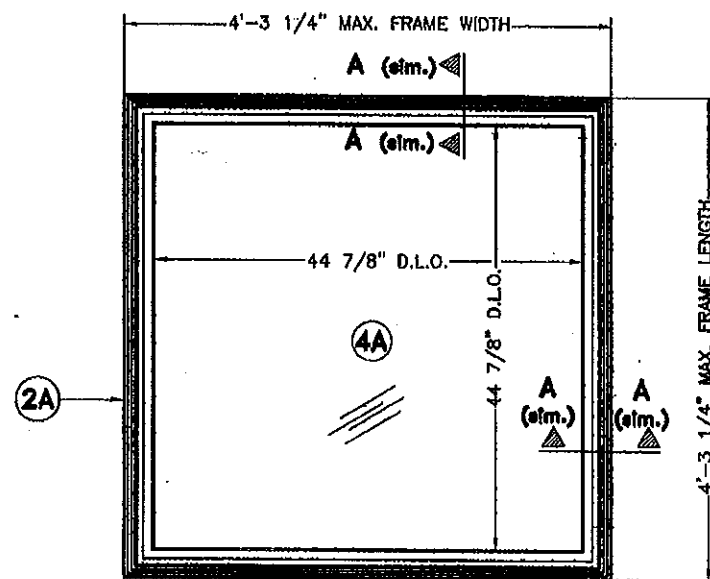


PLAN (INTERIOR SIDE)
N.T.S.

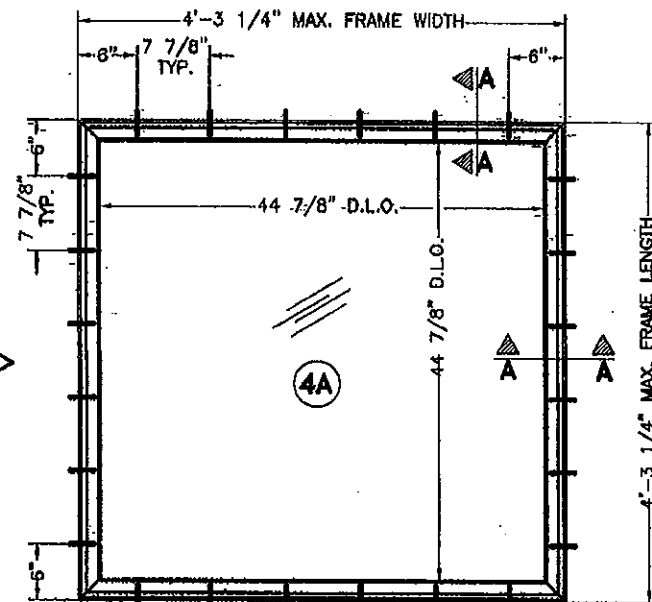


PLAN (EXTERIOR SIDE)
N.T.S.

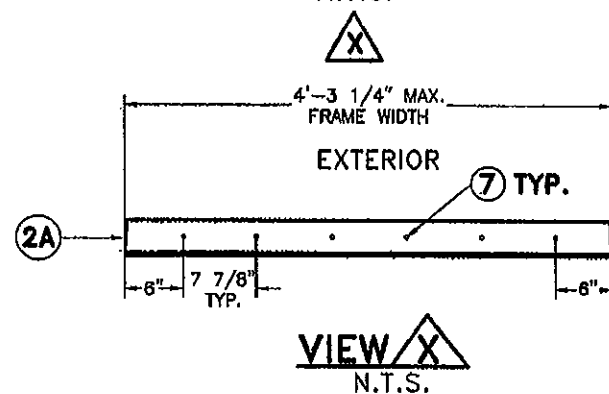



VIEW X
N.T.S.

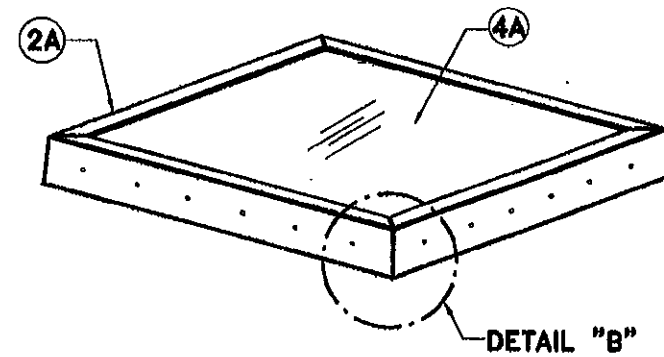

TYPICAL ISOMETRIC
N.T.S.

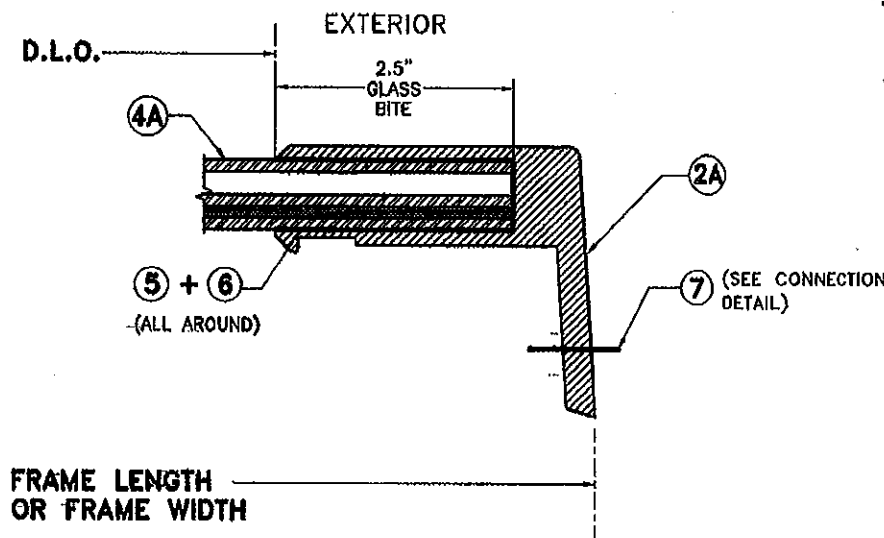

SECTION A-A
SCALE: 1/2"=1"
GLAZING DETAIL

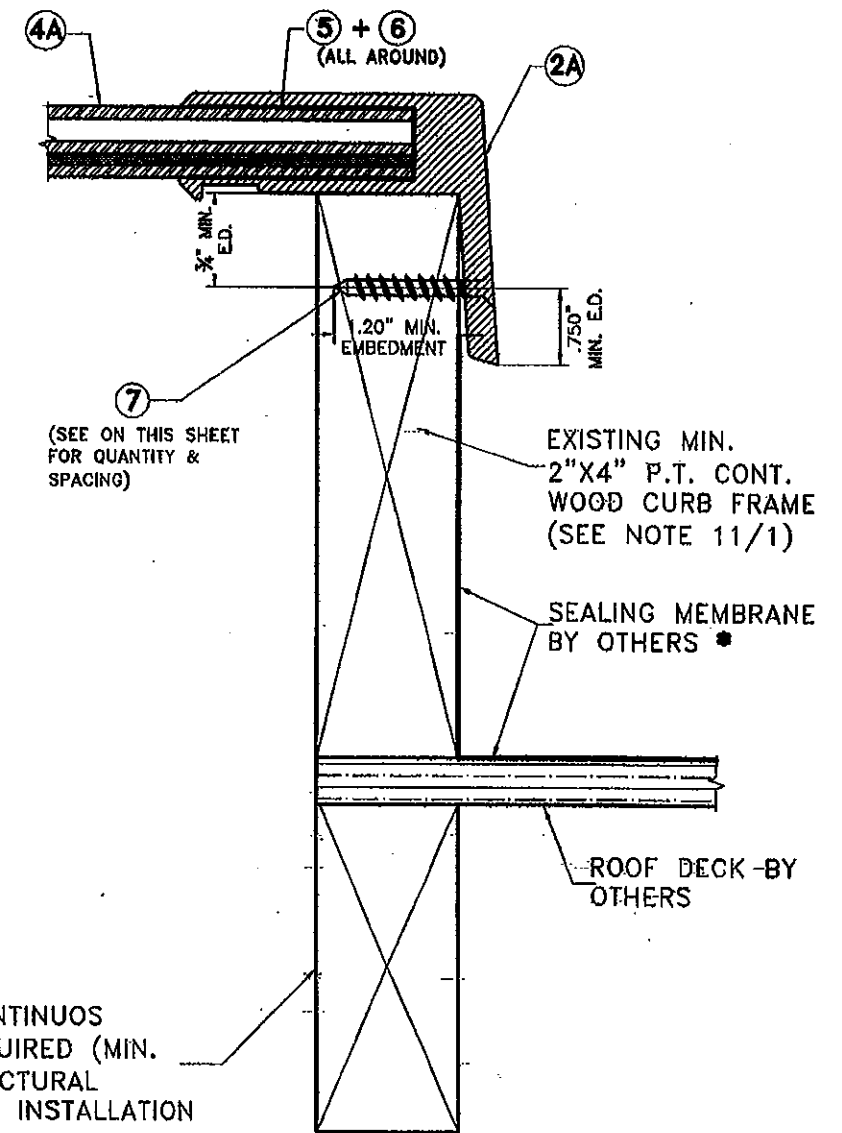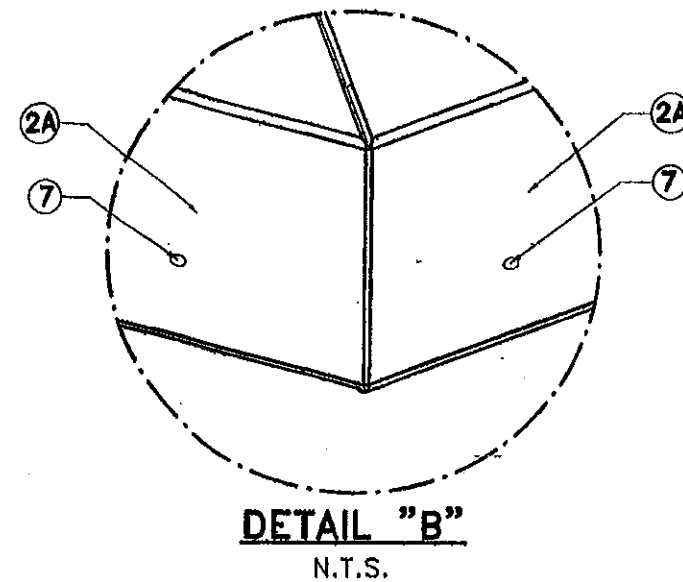

**CONNECTION DETAIL FOR
FRAME CASE 5 (CMC)**
SCALE: 1/2"=1"


*** NOTES:**

1. ALL ROOFING DETAILS SHALL COMPLY WITH SECTIONS 1512 THRU 1525 OF THE FLORIDA BUILDING CODE.

**CASE 5: 4'-3 1/4" x 4'-3 1/4" SERIES
CURB-MOUNTED GLAZED SKYLIGHT (CMC)**

PRODUCT REVISED
to comply with the Florida
Building Code
Acceptance No. 11-1206.05
Expiration Date 06/10/2014
By *[Signature]*
Miami Dade Product Control

MIAMI-DADE COUNTY

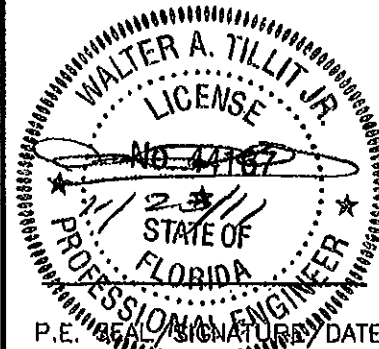

FLORIDA BUILDING CODE (HIGH VELOCITY HURRICANE ZONE)

©2011 TILTECO, INC

TILTECO Inc.
TILLIT TESTING & ENGINEERING COMPANY
6365 N.W. 38th St., Ste. 309, VIRGINIA GARDENS, FL 33166
Phone: (305) 871-1830 • Fax: (305) 871-1831
e-mail: tilteco@aol.com
EB-0008719
WALTER A. TILLIT Jr., P.E.
FLORIDA Lic. # 44167

SERIES SEAMLESS SELF-FLASHING GLAZED SKYLIGHT (SSP),
SERIES CURB-MOUNTED GLAZED SKYLIGHT (CAP) AND
SERIES CURB-MOUNTED GLAZED SKYLIGHT (CMC) LARGE
MISSILE IMPACT RESISTANT-INSULATED GLASS

M.C.V./A.G.
DRAWN BY


11/16/11
DATE

11-118
DRAWING No


V-TECH INDUSTRIES
6634 HARVEY WILSON DRIVE
HOUSTON, TEXAS 77020
PHONE: (888) 491-0843

REV. No	DESCRIPTION	DATE	REV. No	DESCRIPTION	DATE
1	OLD 10-055	11/16/11	3		
2			4		

SHEET 7A OF 8

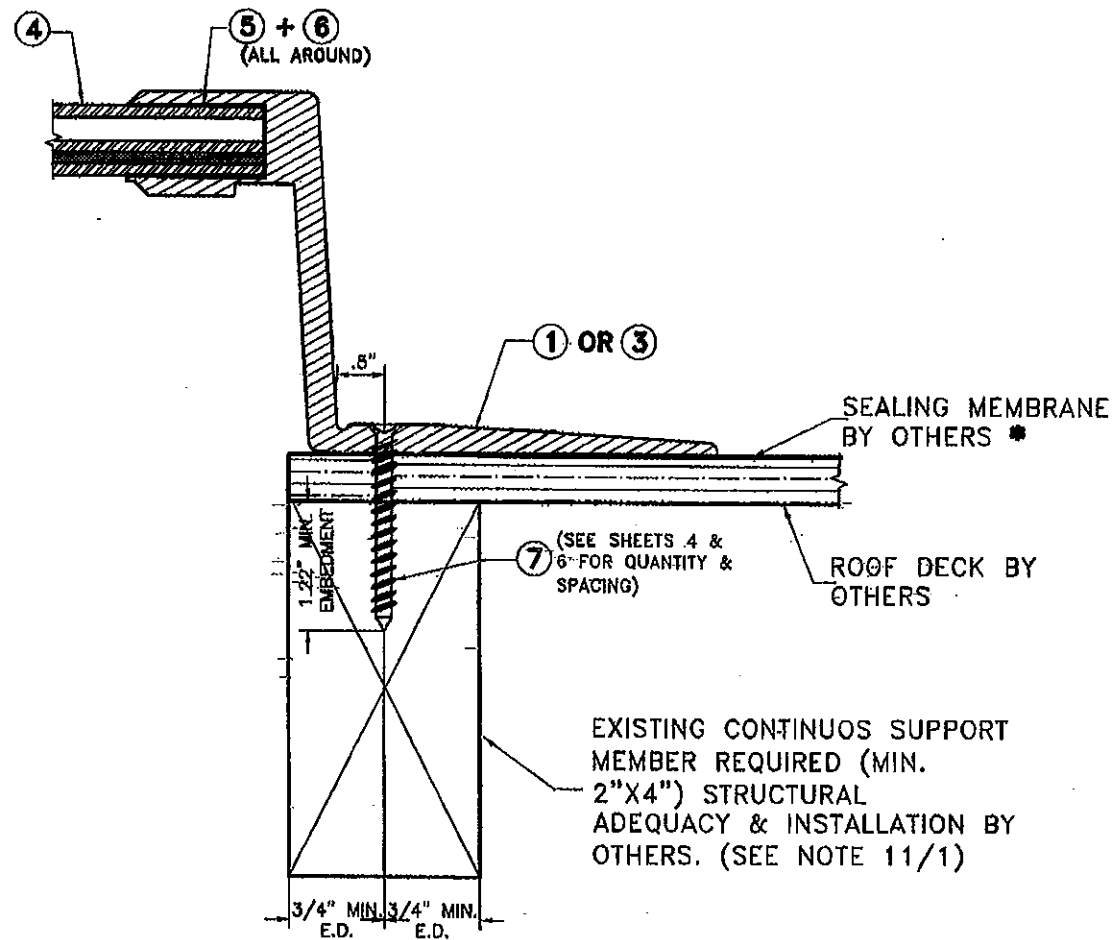

**CONNECTION DETAIL FOR FRAME
CASES 1 & 3 (SSF)**

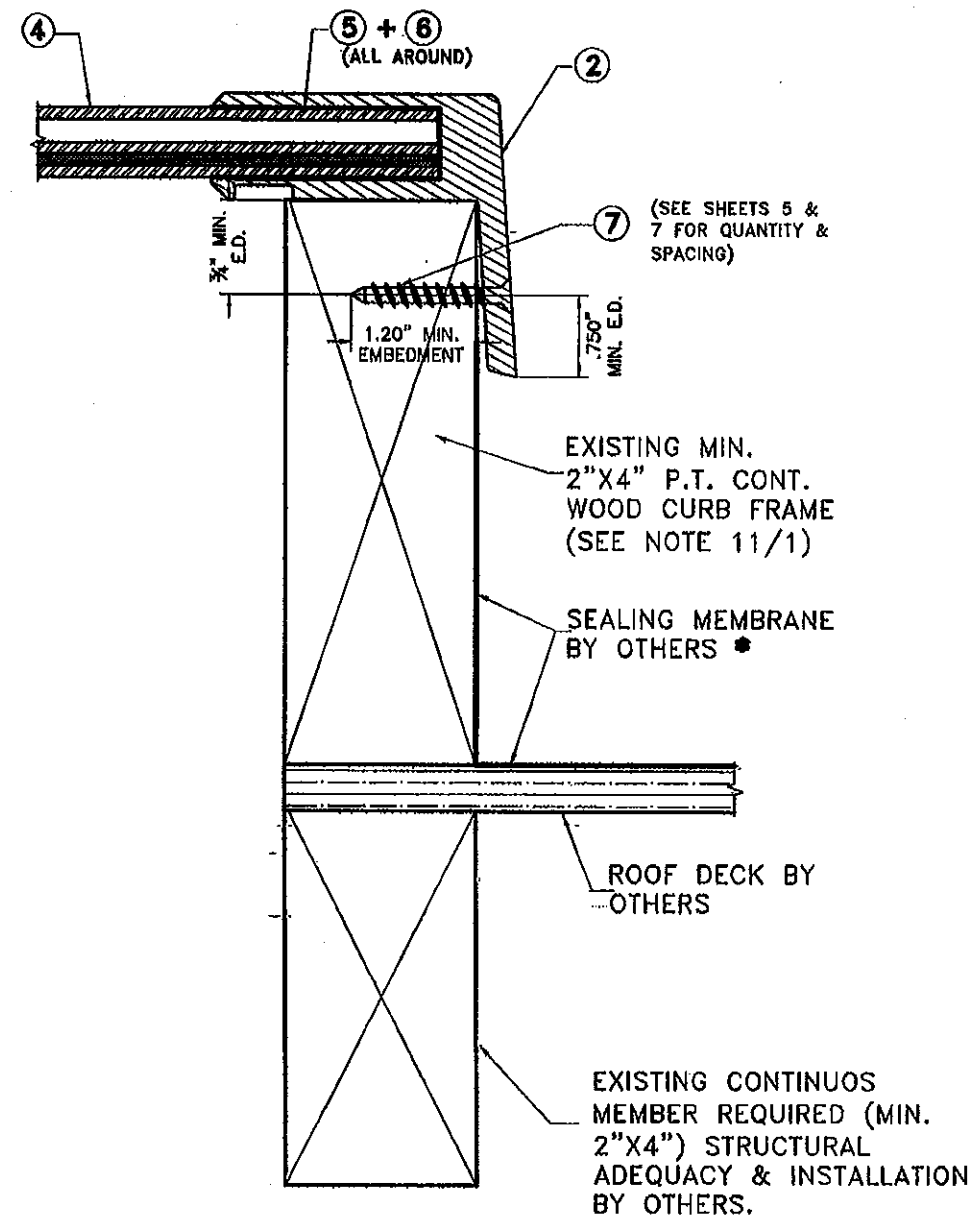

**CONNECTION DETAIL FOR FRAME
CASES 2 & 4 (CAP)**

*** NOTES:**


1. ALL ROOFING DETAILS SHALL COMPLY WITH SECTIONS 1512 THRU 1525 OF THE FLORIDA BUILDING CODE.

CONNECTION DETAILS

SCALE: 1/2"=1"

PRODUCT REVISED
as complying with the Florida
Building Code
Acceptance No. 11-1206-05
Expiration Date 06/16/2014
By *[Signature]*
Miami Dade Product Control

MIAMI-DADE COUNTY

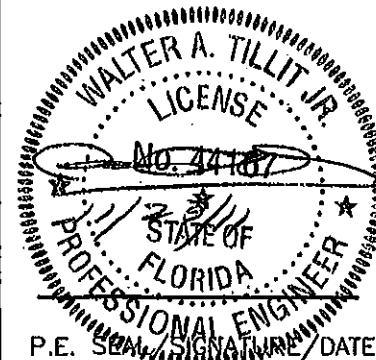

P.E. SIGNATURE/DATE

FLORIDA BUILDING CODE (HIGH VELOCITY HURRICANE ZONE)

©2011 TILTECO, INC

TILTECO inc.
TILLIT TESTING & ENGINEERING COMPANY
6355 N.W. 38th St., Ste. 305, VIRGINIA GARDENS, FL 33166
Phone : (305)871-1530 • Fax : (305)871-1531
e-mail: tiltco@eol.com
EG-0006719
WALTER A. TILLIT Jr., P.E.
FLORIDA Lic. # 44167

SERIES SEAMLESS SELF-FLASHING GLAZED SKYLIGHT (SSF),
SERIES CURB-MOUNTED GLAZED SKYLIGHT (CAP) AND
SERIES CURB-MOUNTED GLAZED SKYLIGHT (CMC) LARGE
MISSILE IMPACT RESISTANT-INSULATED GLASS

M.C.V./A.G.
DRAWN BY

V-TECH INDUSTRIES

5534 HARVEY WILSON DRIVE
HOUSTON, TEXAS 77020
PHONE: (866) 491-0843

11/16/11
DATE

11-118

DRAWING No

REV. No	DESCRIPTION	DATE	REV. No	DESCRIPTION	DATE
1	OLD 10-085	11/16/11	3	-	-
2	-	-	4	-	-

SHEET 8 OF 8